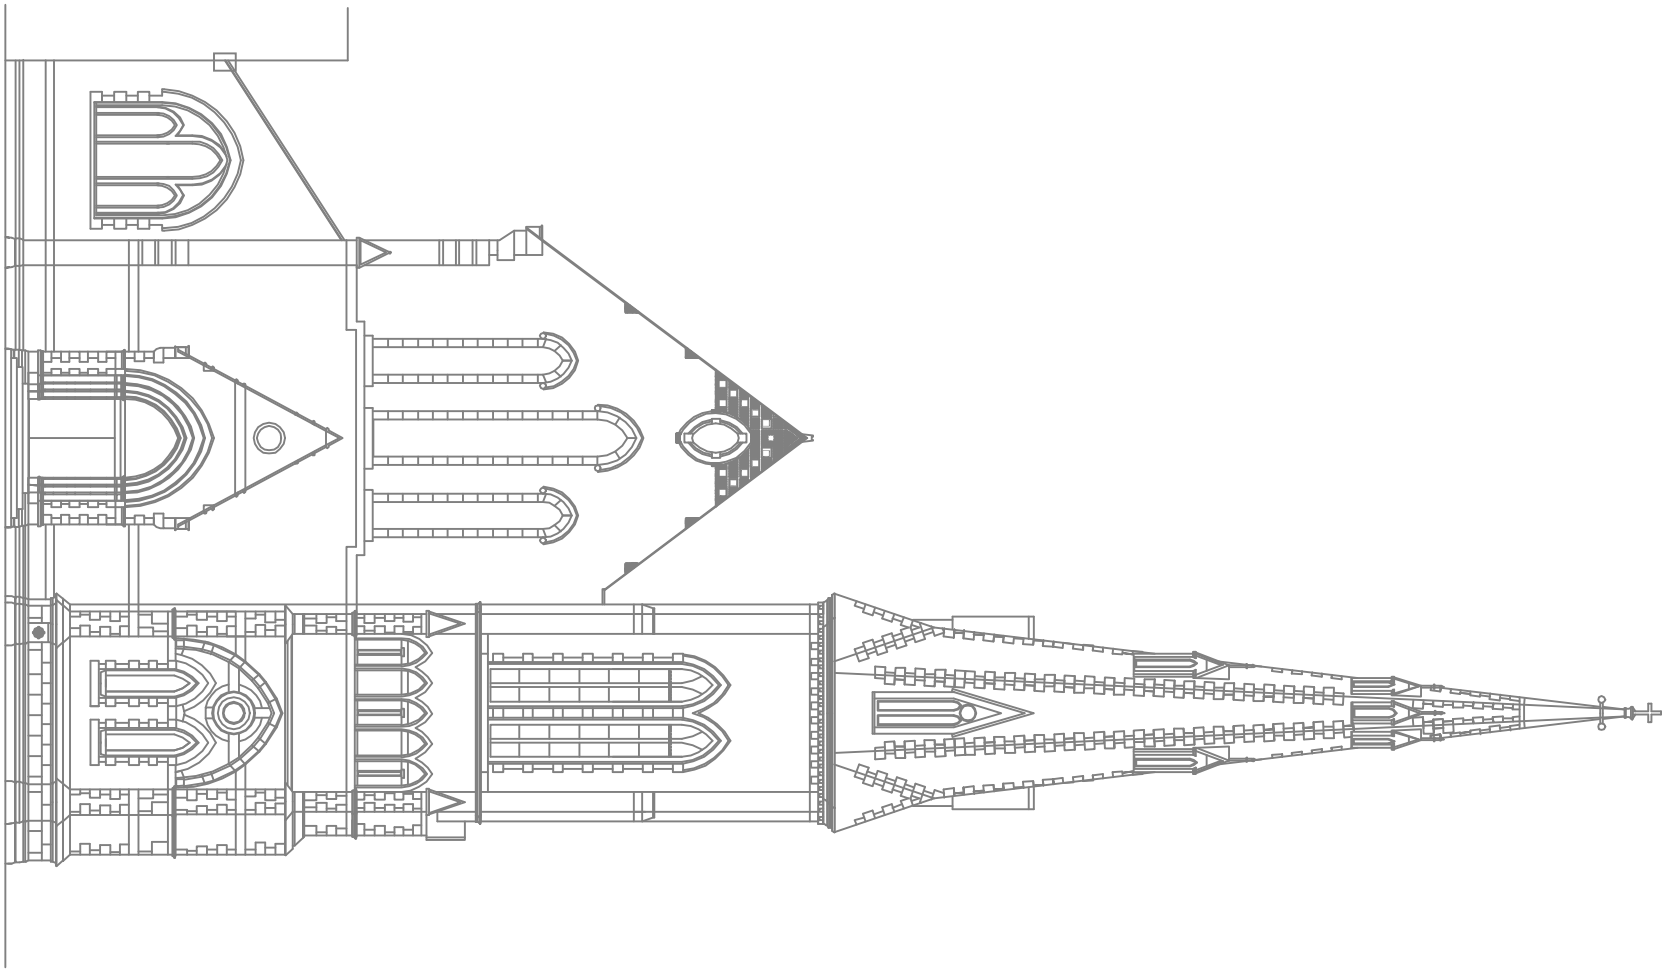

1 EX-1 Existing Exterior Elevation Main Facade
SCALE 1/4"=1'-0"

Church of the Advent

30 Brimmer Street
Boston, MA.

Existing Exterior Elevations

Existing Conditions Surveys Inc.

475 Shawmut Ave, #2
Boston, MA 02118 USA

T 617.598.0723
F 617.249.0746
E info@existingconditions.com

The Most Accurate and Efficient Existing Conditions Surveys and As-Built Surveys

No.	Date	Revision	By

No.	Date	Issued to	By

Title
Existing Exterior Elevations

Date	01.15.2001
Scale	1"=1'-0"
Job No.	0102
Drawn By:	KJY

EX-1